



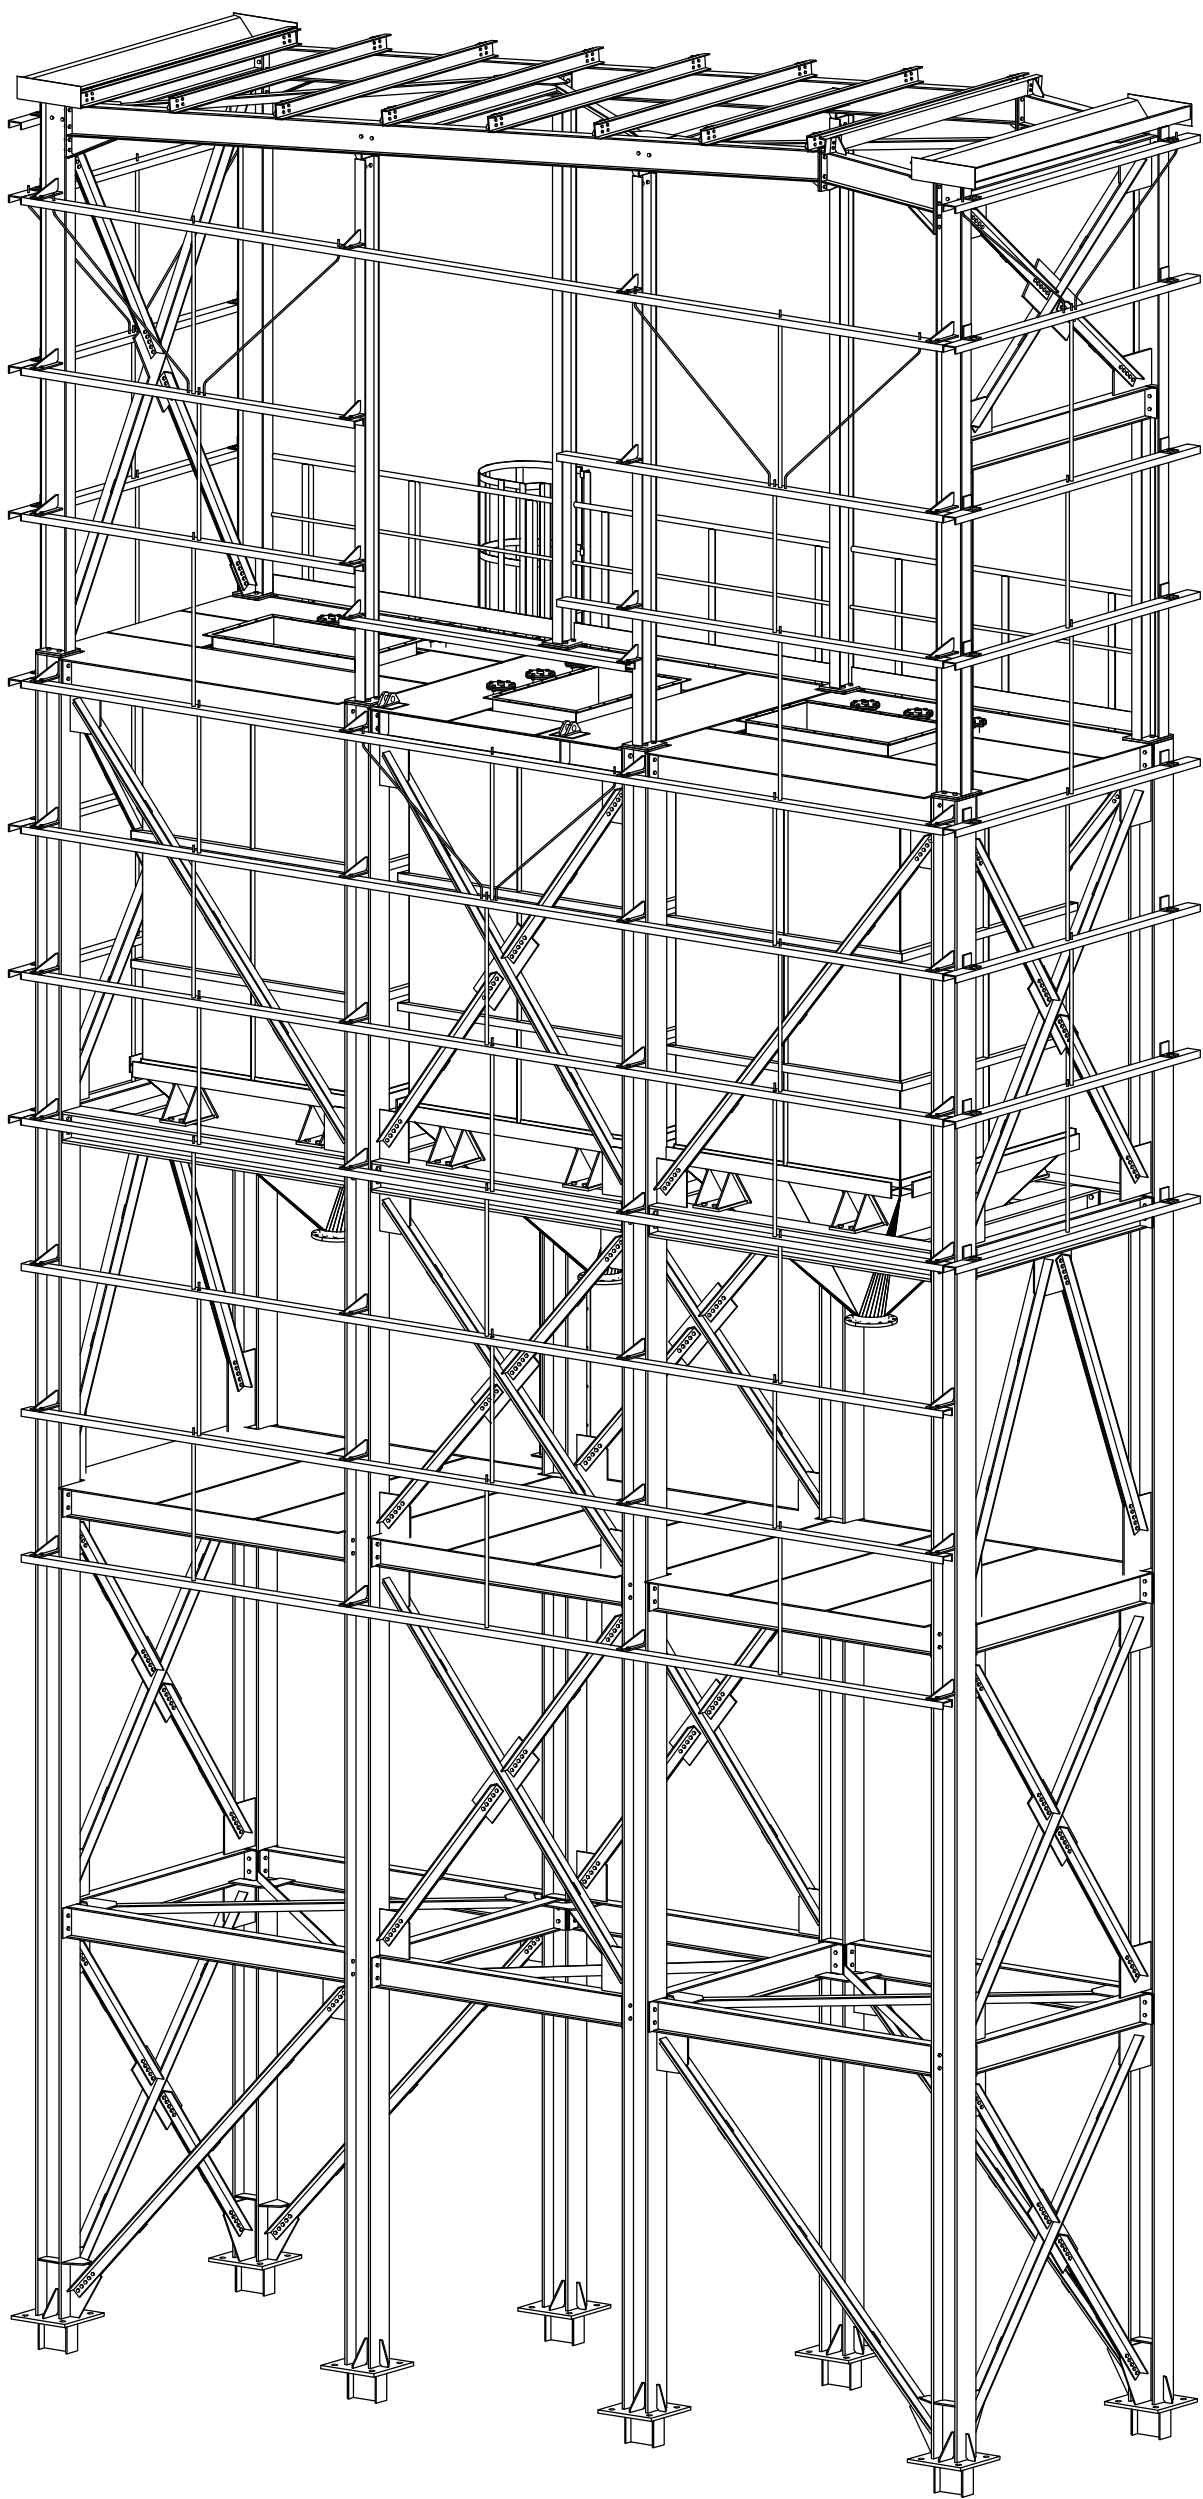

3d

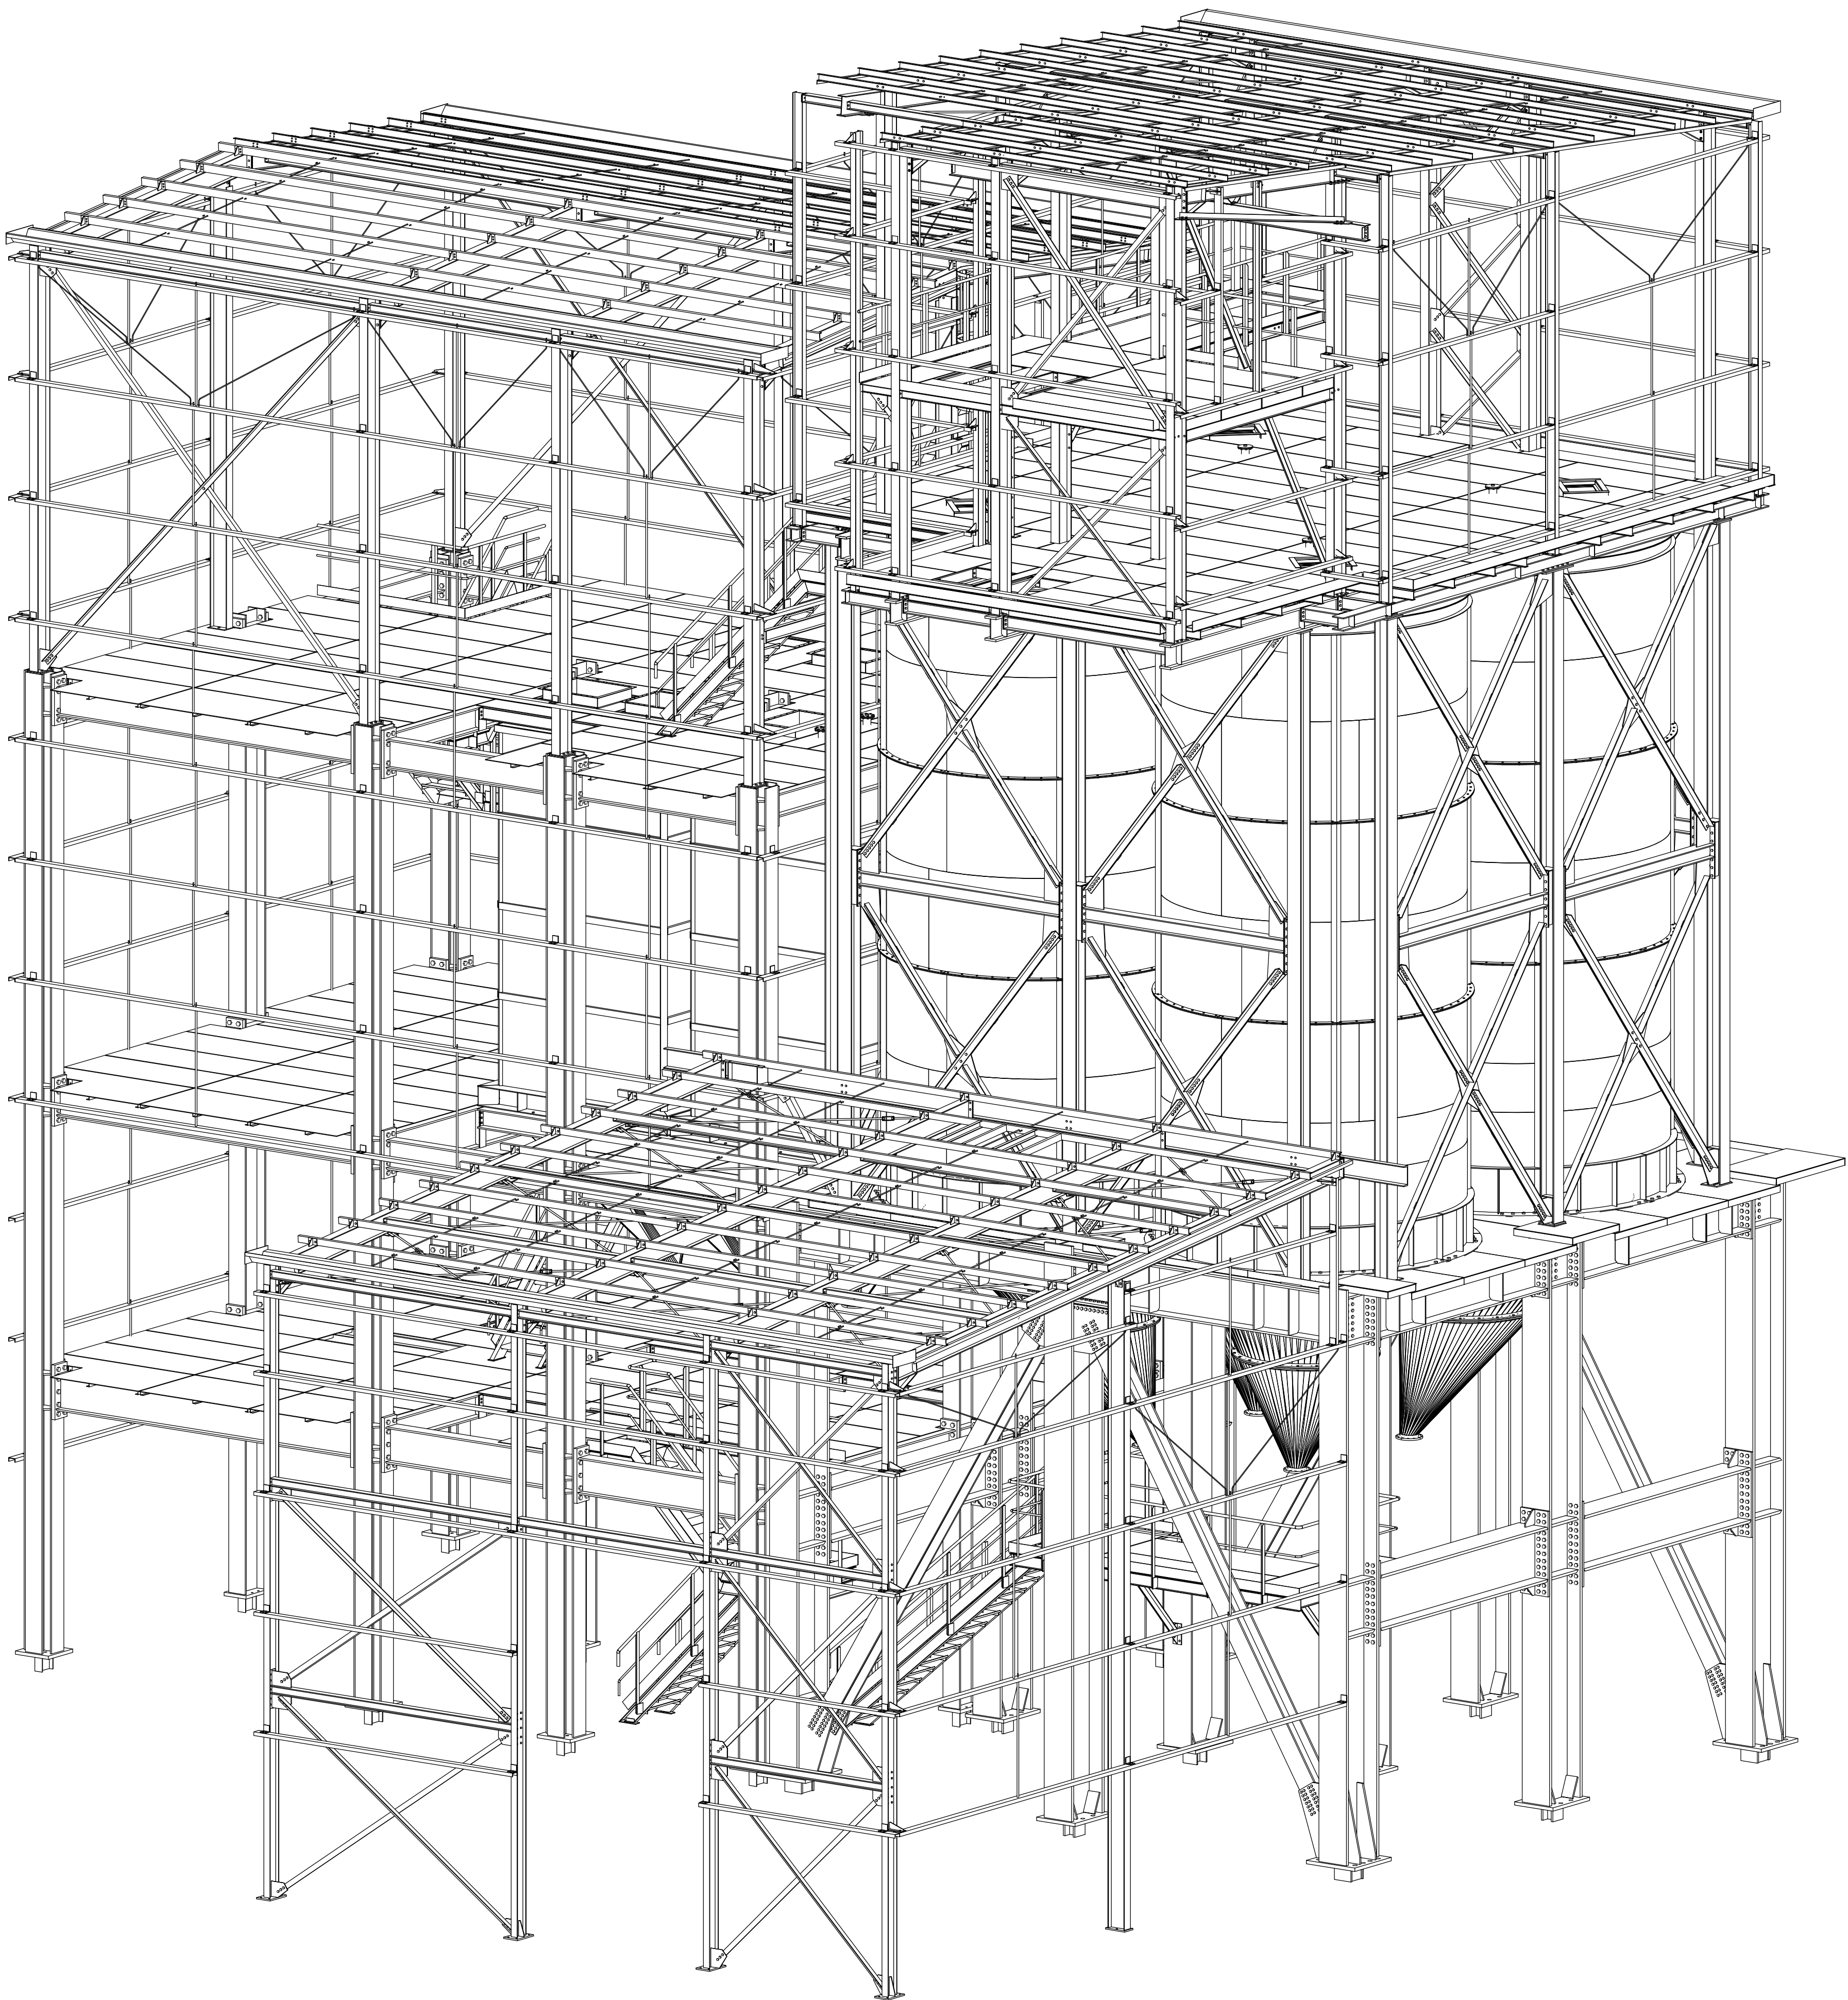

Tekla structures

Asbuilt	1400/12/07	ISSUED FOR CONSTRUCTION	M.Safae	Amini	Tahmasebi
Rev.	Date	DESCRIPTION	Prepared	Checked	Approved
Client		DESCRIPTION :			Contractor
		STEEL STRUCTURE OF SILOS & TRUCK UNLOADING STRUCTURE			
		Drawing Title: GLASS WOOL PRODUCTION LINE TRANSFER			
File No. : GWPD20005C301001-2			Size: A1		Scale:1/80 N.T.S